


1 AS-BUILT PLAN
SCALE: 1/8" = 1'-0"



2 AS-BUILT ELEVATION
SCALE: 1/8" = 1'-0"

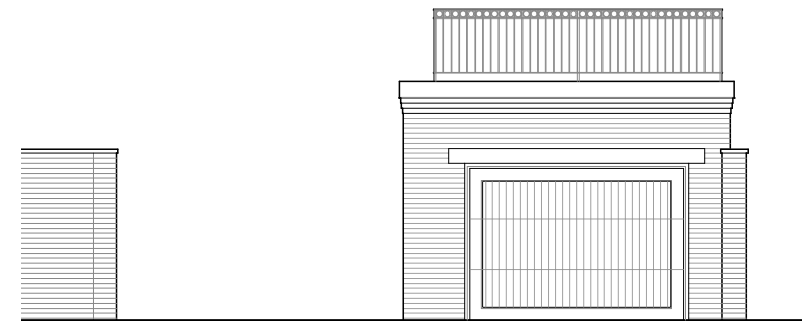

FRANK SHIRLEY
ARCHITECTS

40 Pearl Street Cambridge MA 02139 t: 617.547.3355 f: 617.547.2385
www.frankshirleyarchitects.com

PROJECT

Alterations to:
55 COMMONWEALTH AVE.
Boston, MA 02116

THESE EXISTING PLANS AND/OR PHOTOGRAPHS ARE A REPRESENTATION OF THE EXISTING CONDITIONS OF THE BUILDING. THESE DRAWINGS/PHOTOGRAPHS ARE FOR THE GENERAL CHARACTERISTICS OF THE EXISTING CONDITIONS AND NOT AN EXHAUSTIVE INVESTIGATION INTO ACTUAL EXISTING CONDITIONS. THE INFORMATION IS FOR COORDINATION OF THE WORK TO BE PERFORMED BY THE GENERAL CONTRACTOR. THE ARCHITECT BEARS NO RESPONSIBILITY FOR THE ACCURACY OF THE INFORMATION. THE GENERAL CONTRACTOR SHALL EXAMINE THESE CONDITIONS IN THE FIELD PRIOR TO CONSTRUCTION AND BECOME FAMILIAR WITH THE WORK. AFTER EXAMINATION OF THE EXISTING CONDITIONS, THE GENERAL CONTRACTOR SHALL VERIFY ALL CONDITIONS AND DIMENSIONS AND NOTIFY THE ARCHITECT OF ANY DISCREPANCIES BETWEEN THE EXISTING CONDITIONS AND THE NEW PROPOSED WORK. ALL WORK CONSTRUCTED PRIOR TO NOTIFICATION THAT DOES NOT CONFORM TO THE DESIGN OR LAYOUT OF THE PLANS AND DIMENSIONS SHALL BE REPLACED BY THE GENERAL CONTRACTOR.

ISSUES / REVISIONS

Date	Description
22 DEC 16	AS-BUILT PLAN
24 JAN 17	AS-BUILT ELEVATION

© FRANK SHIRLEY ARCHITECTS, 2017. All rights reserved.
This drawing cannot be reproduced without permission.

DRAWING TITLE

As-Built Plan, Elevations, & Photographs

SCALE

1/4" = 1'-0"

DATE

January 24, 2017

SHEET NUMBER

AB-1

